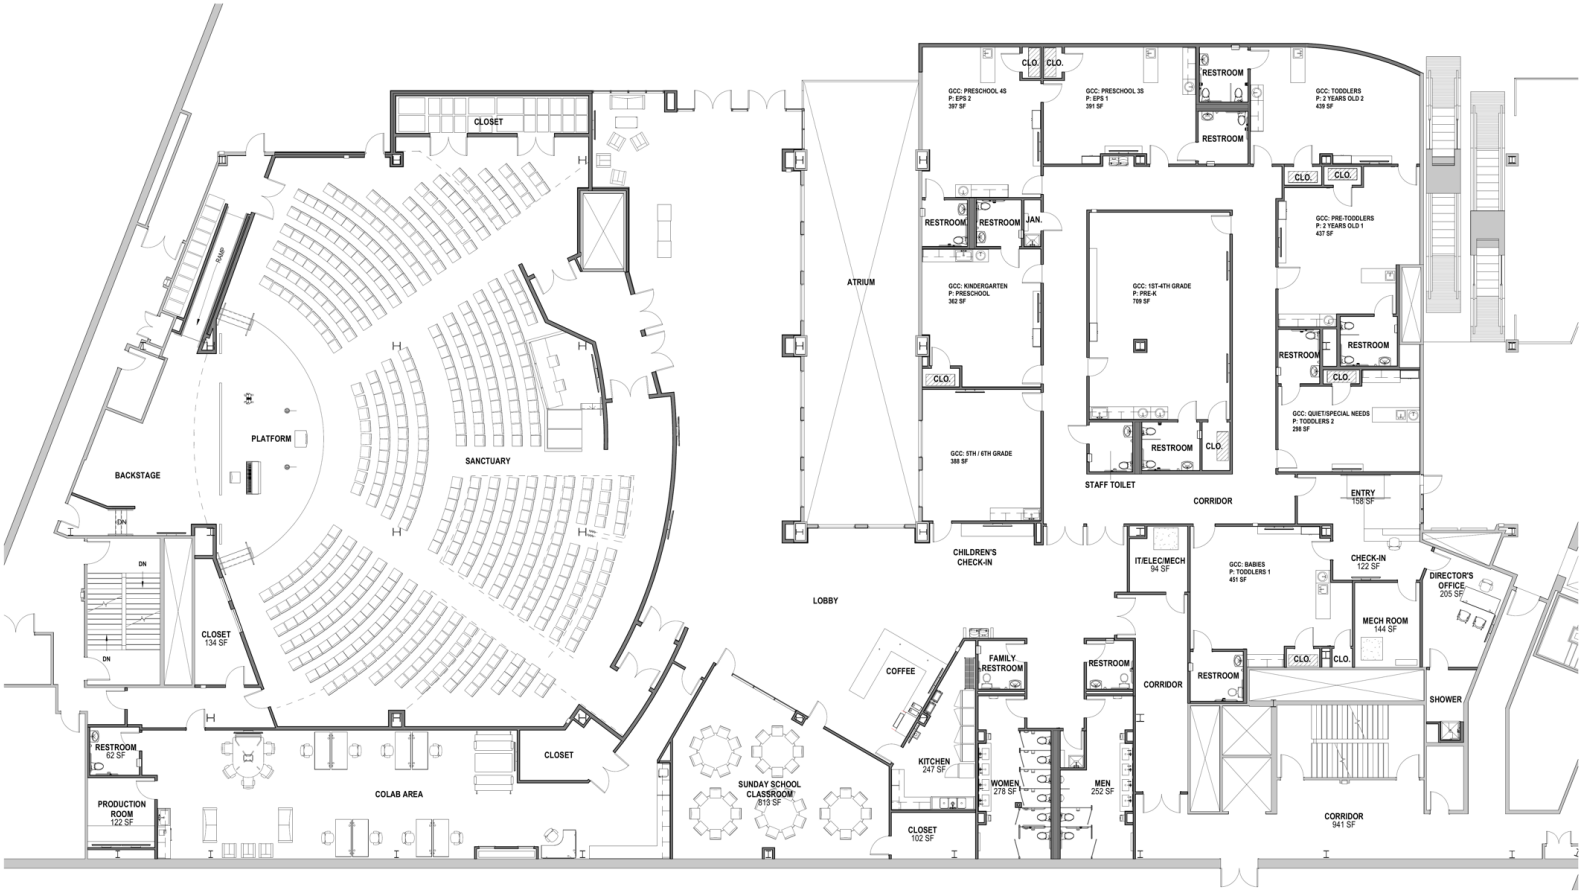



TOTAL TENANT SPACE = 23,403 SF

GRACE COMMUNITY CHURCH

GRACE COMMUNITY CHURCH TENANT FIT-OUT

4238 WILSON BOULEVARD
ARLINGTON, VA 22203

FLOOR PLAN
2/1/2023

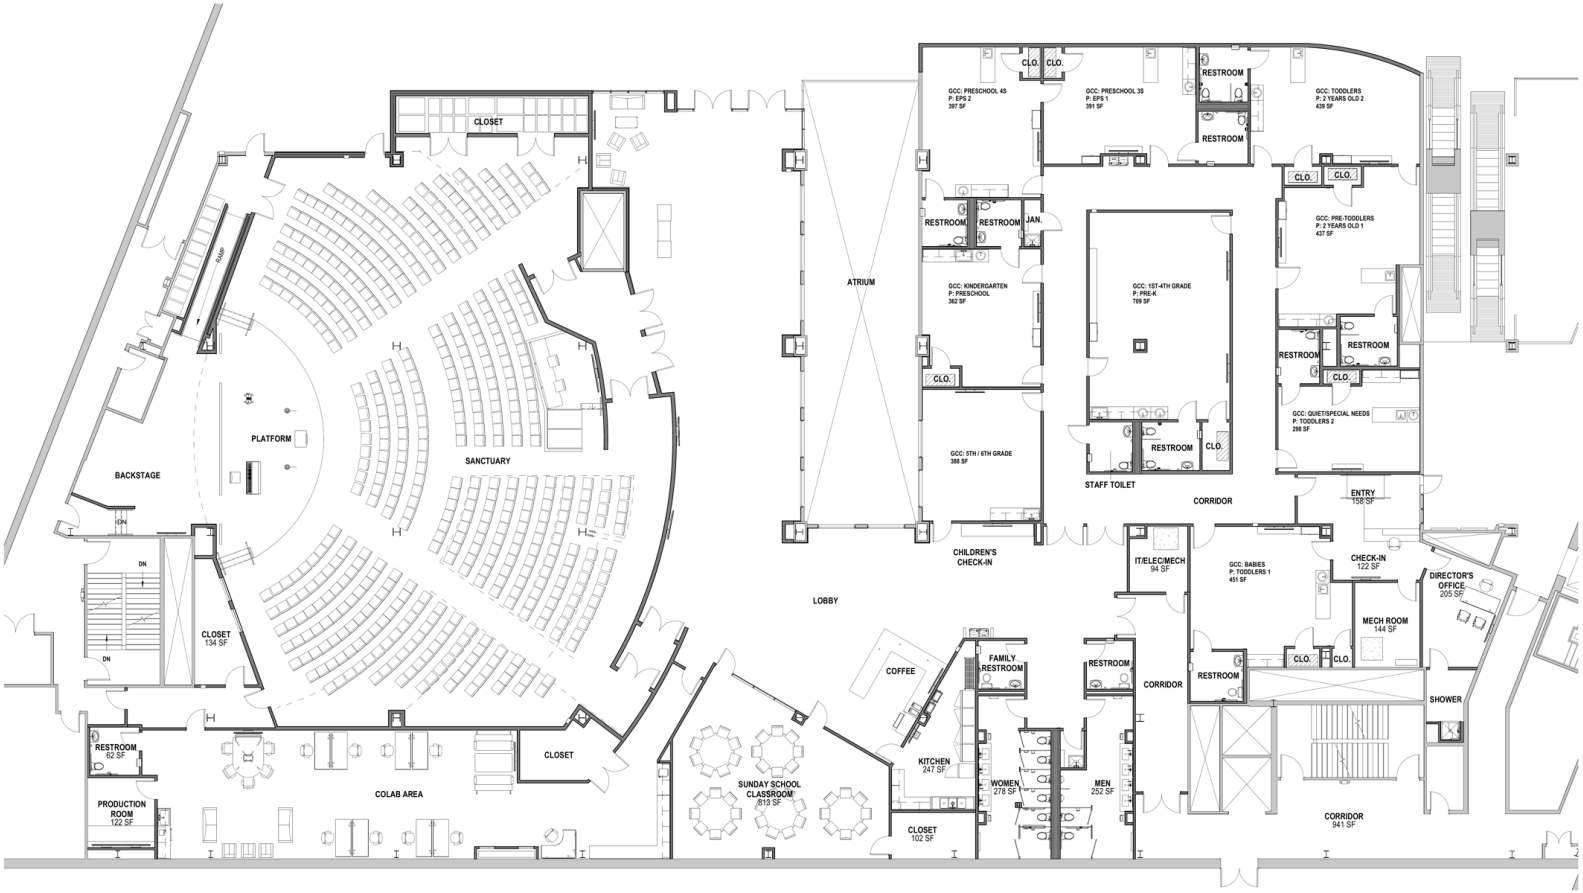

TOTAL TENANT SPACE = 23,403 SF

SCALE 1/8" = 1'-0"


WALDONSTUDIO ARCHITECTS

GRACE COMMUNITY CHURCH

GRACE COMMUNITY CHURCH TENANT FIT-OUT

4238 WILSON BOULEVARD
ARLINGTON, VA 22203

FLOOR PLAN
2/1/2023

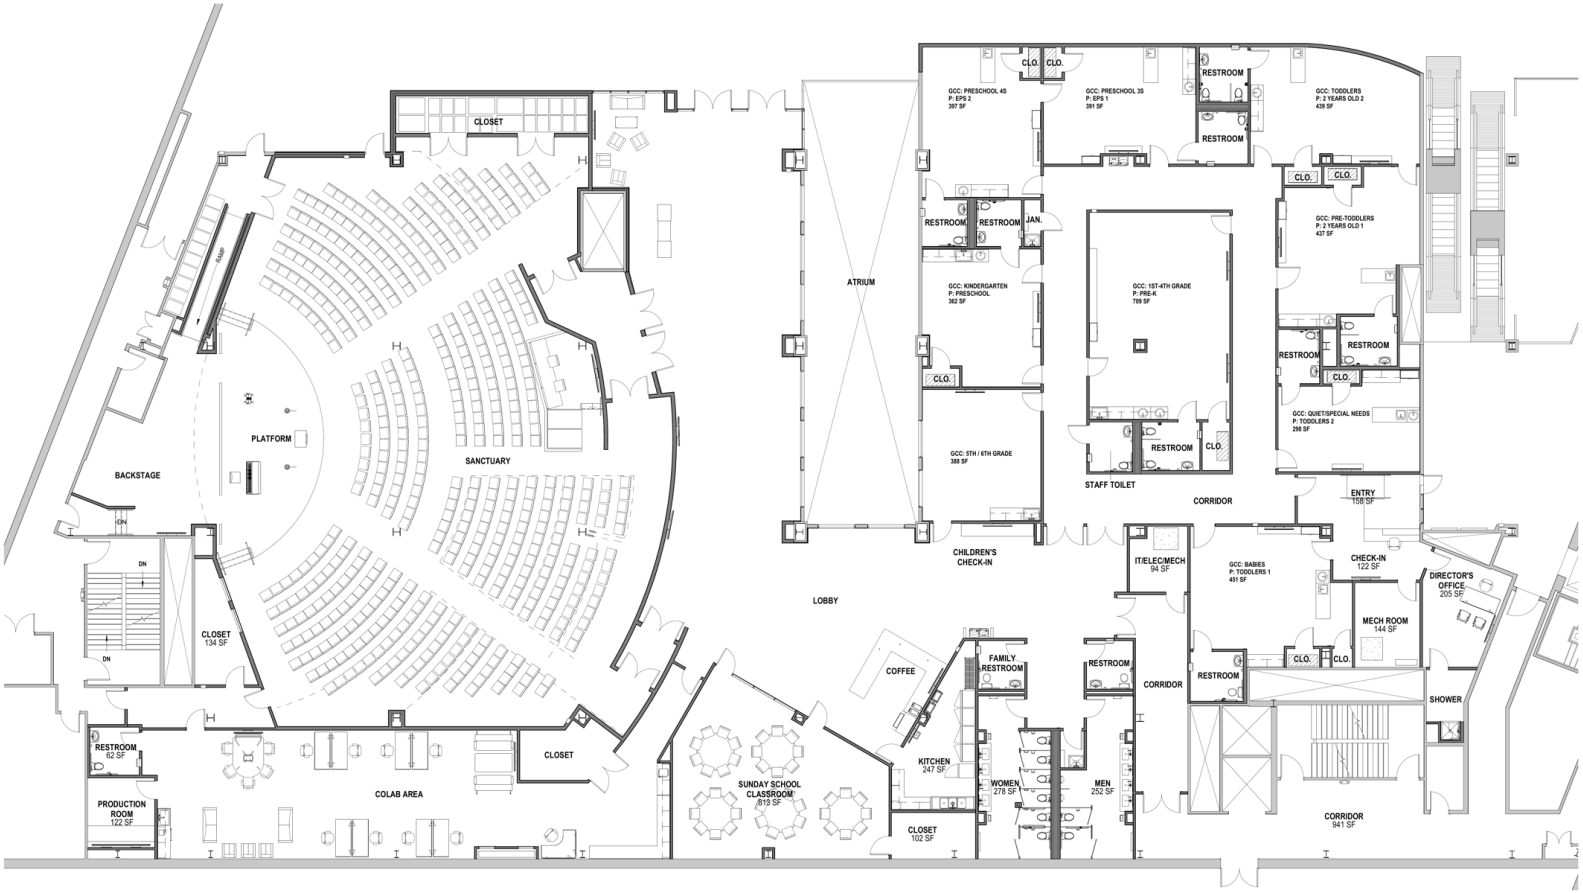

TOTAL TENANT SPACE = 23,403 SF

SCALE 1/8" = 1'-0"


WALDONSTUDIO ARCHITECTS


GRACE COMMUNITY CHURCH


GRACE COMMUNITY CHURCH TENANT FIT-OUT

4238 WILSON BOULEVARD
ARLINGTON, VA 22203

FLOOR PLAN
2/1/2023

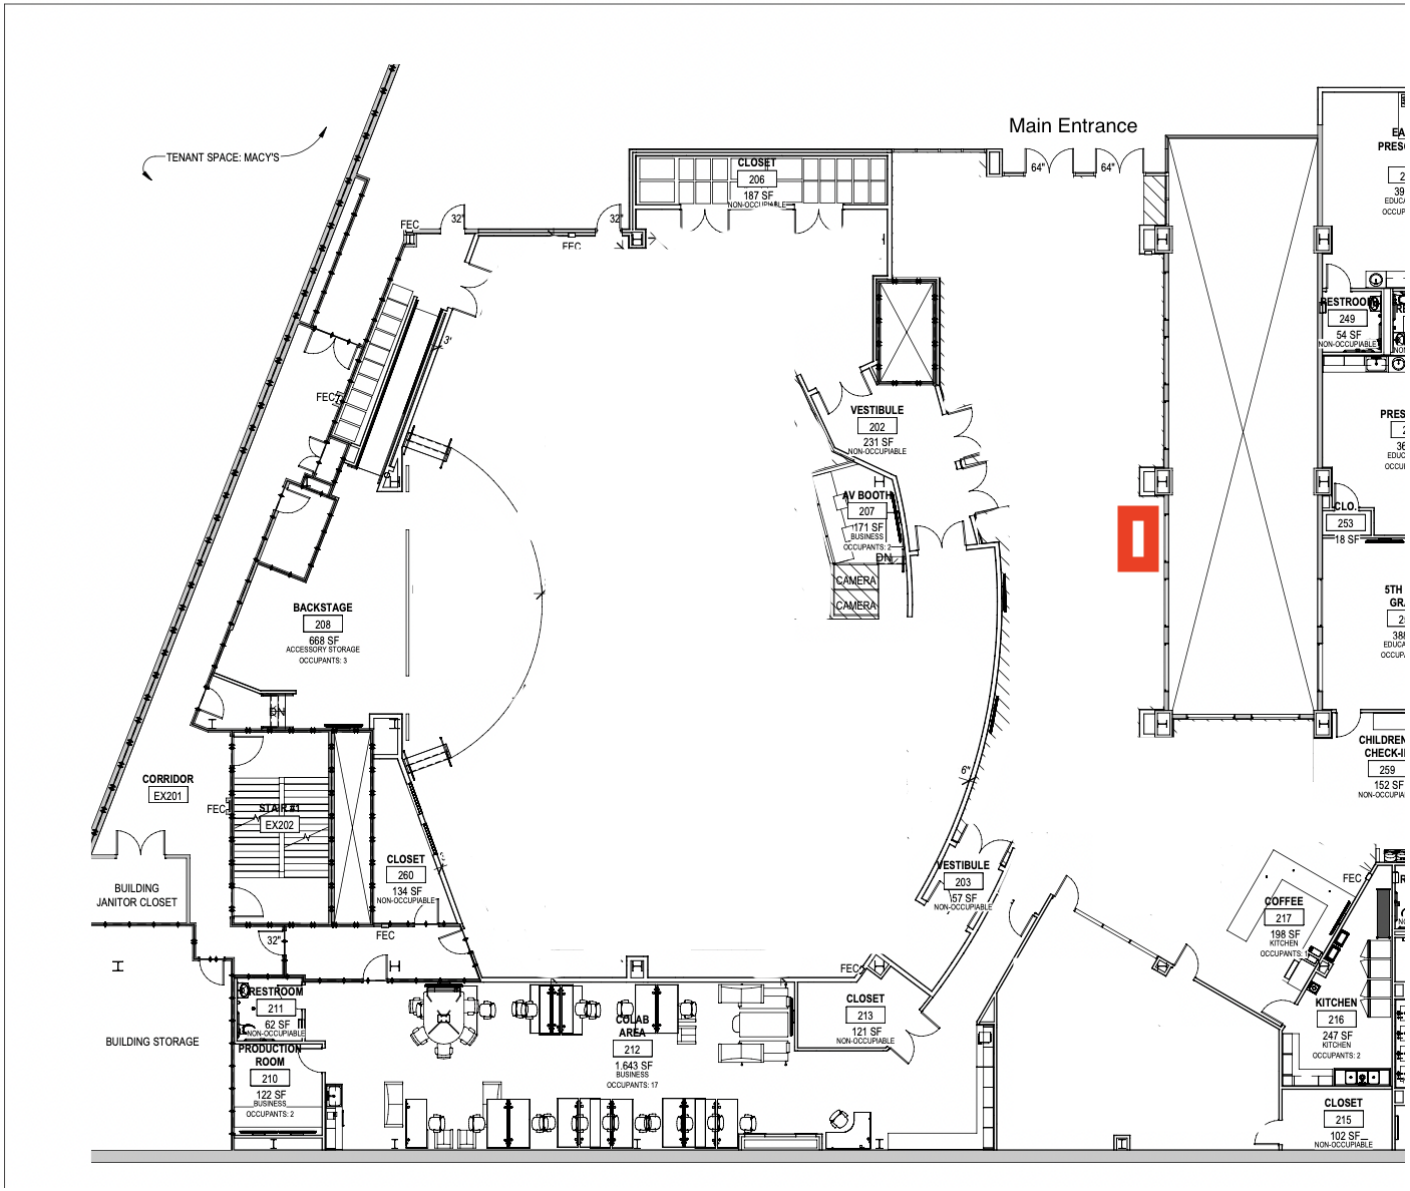
Main Entrance
TENANT SPACE: MACY'S
CLOSET
206
187 SF
NON-OCCUPIABLE
VESTIBULE
202
231 SF
NON-OCCUPIABLE
AV BOOTH
207
171 SF
BUSINESS
OCCUPANTS: 2
CAMERA
CAMERA
BACKSTAGE
208
668 SF
ACCESSORY STORAGE
OCCUPANTS: 3
CORRIDOR
EX201
STAIR #1
EX202
CLOSET
260
134 SF
NON-OCCUPIABLE
BUILDING JANITOR CLOSET
BUILDING STORAGE
RESTROOM
211
62 SF
NON-OCCUPIABLE
PRODUCTION ROOM
210
122 SF
BUSINESS
OCCUPANTS: 2
COLAB AREA
212
1,643 SF
BUSINESS
OCCUPANTS: 17
VESTIBULE
203
157 SF
NON-OCCUPIABLE
CLOSET
213
121 SF
NON-OCCUPIABLE
COFFEE
217
198 SF
KITCHEN
KITCHEN
216
247 SF
KITCHEN
OCCUPANTS: 2
CLOSET
215
102 SF
NON-OCCUPIABLE
RESTROOM
249
54 SF
NON-OCCUPIABLE
CLO
253
18 SF
CHILDREN
CHECK-I
259
152 SF
NON-OCCUPIA
FEC
64"
32"

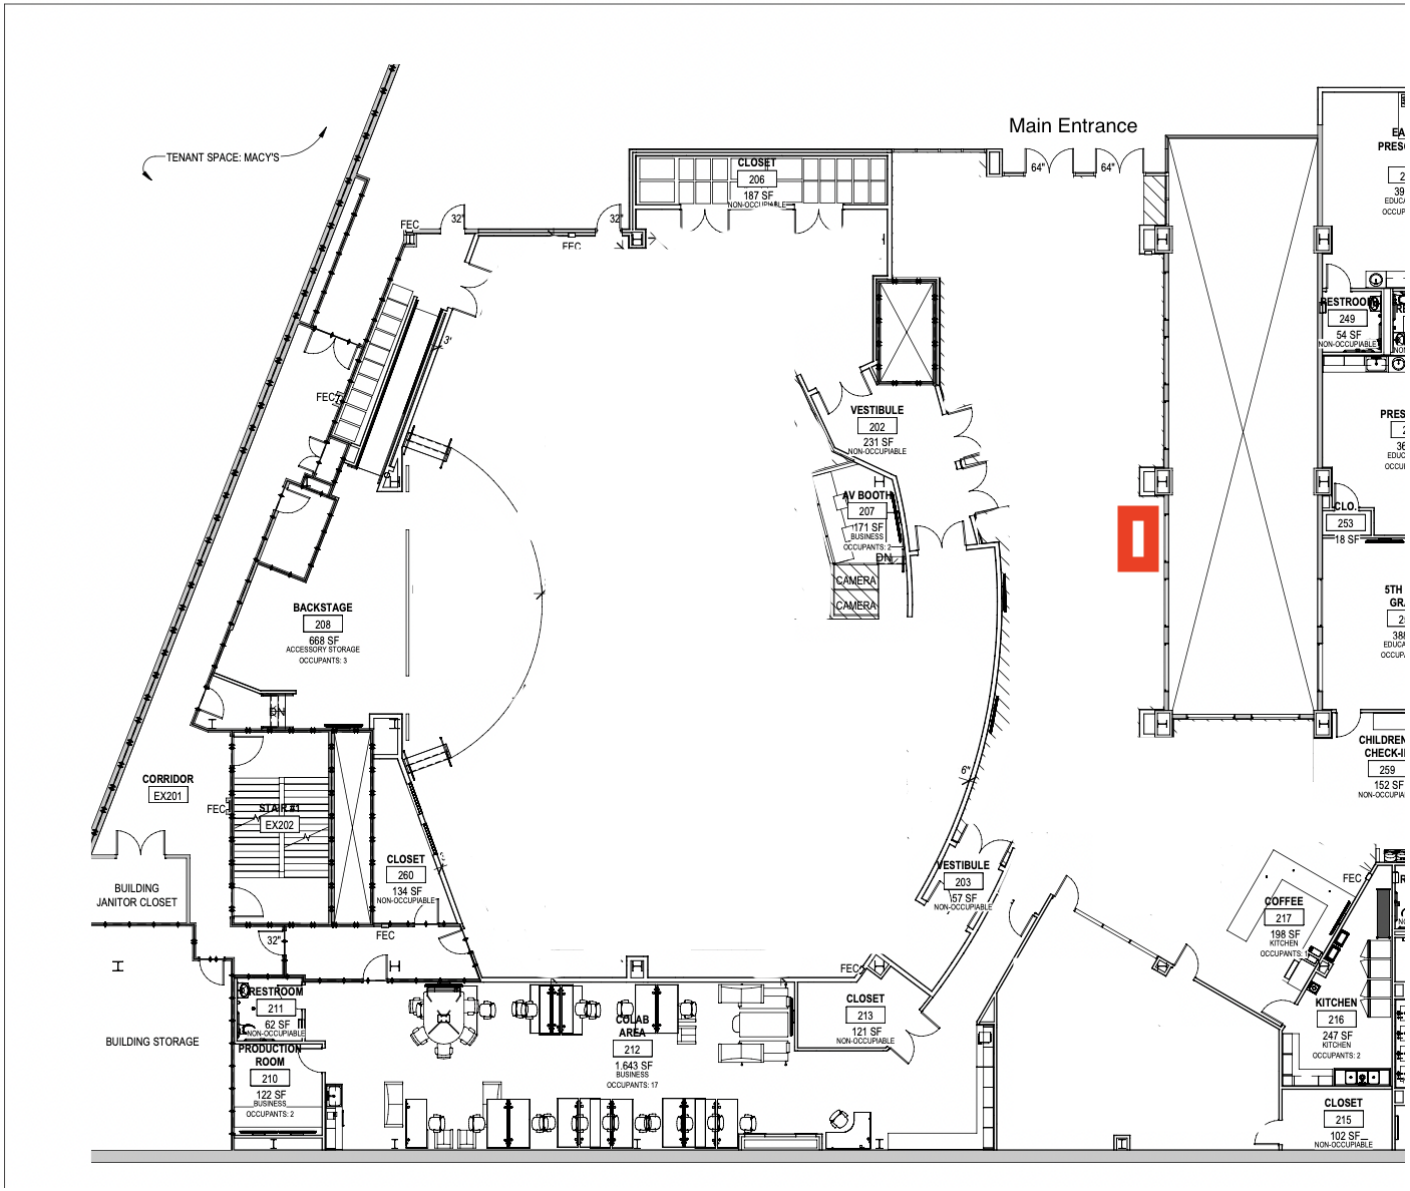
Main Entrance
TENANT SPACE: MACY'S
CLOSET
206
187 SF
NON-OCCUPIABLE
VESTIBULE
202
231 SF
NON-OCCUPIABLE
AV BOOTH
207
171 SF
BUSINESS
OCCUPANTS: 2
CAMERA
CAMERA
BACKSTAGE
208
668 SF
ACCESSORY STORAGE
OCCUPANTS: 3
CORRIDOR
EX201
STAIR #1
EX202
CLOSET
260
134 SF
NON-OCCUPIABLE
BUILDING JANITOR CLOSET
BUILDING STORAGE
RESTROOM
211
62 SF
NON-OCCUPIABLE
PRODUCTION ROOM
210
122 SF
BUSINESS
OCCUPANTS: 2
COLAB AREA
212
1,643 SF
BUSINESS
OCCUPANTS: 17
VESTIBULE
203
157 SF
NON-OCCUPIABLE
CLOSET
213
121 SF
NON-OCCUPIABLE
COFFEE
217
198 SF
KITCHEN
KITCHEN
216
247 SF
KITCHEN
OCCUPANTS: 2
CLOSET
215
102 SF
NON-OCCUPIABLE
RESTROOM
249
54 SF
NON-OCCUPIABLE
CLO
253
18 SF
CHILDREN
CHECK-I
259
152 SF
NON-OCCUPIA
FEC
64"
32"

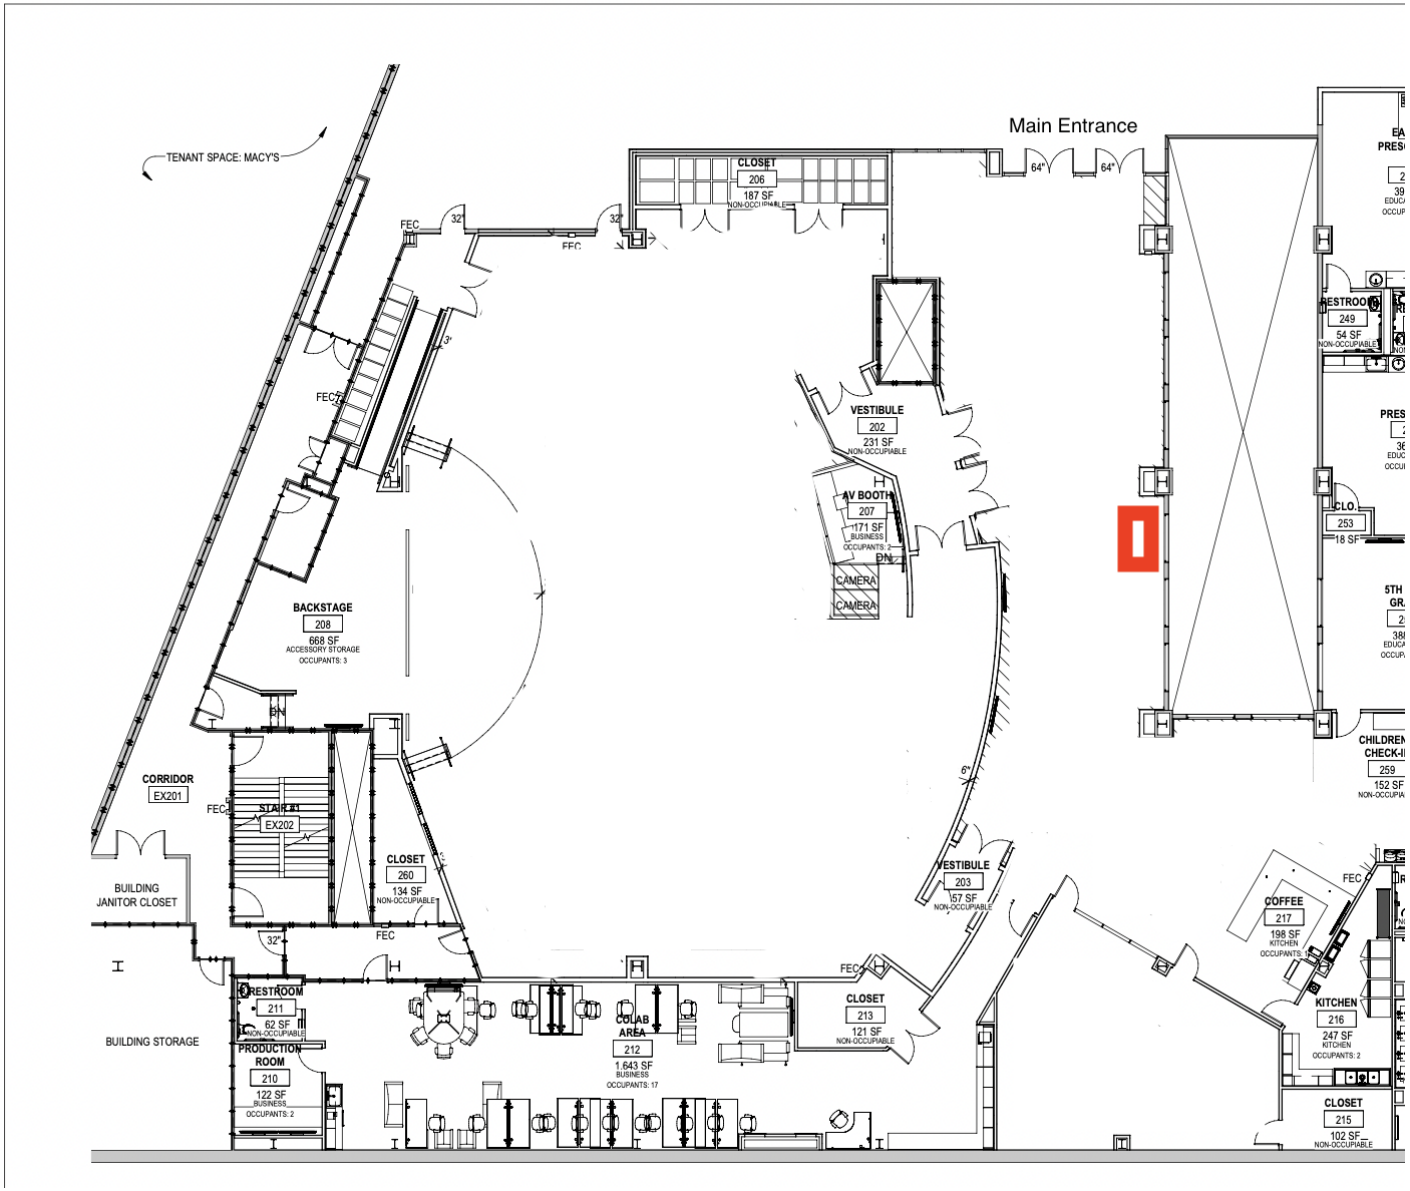
Main Entrance
TENANT SPACE: MACY'S
CLOSET
206
187 SF
NON-OCCUPIABLE
VESTIBULE
202
231 SF
NON-OCCUPIABLE
AV BOOTH
207
171 SF
BUSINESS
OCCUPANTS: 2
DN
CAMERA
CAMERA
BACKSTAGE
208
668 SF
ACCESSORY STORAGE
OCCUPANTS: 3
CORRIDOR
EX201
STAIR #1
EX202
CLOSET
260
134 SF
NON-OCCUPIABLE
BUILDING JANITOR CLOSET
BUILDING STORAGE
RESTROOM
211
62 SF
NON-OCCUPIABLE
PRODUCTION ROOM
210
122 SF
BUSINESS
OCCUPANTS: 2
COLAB AREA
212
1,643 SF
BUSINESS
OCCUPANTS: 17
VESTIBULE
203
157 SF
NON-OCCUPIABLE
CLOSET
213
121 SF
NON-OCCUPIABLE
COFFEE
217
198 SF
KITCHEN
KITCHEN
216
247 SF
KITCHEN
OCCUPANTS: 2
CLOSET
215
102 SF
NON-OCCUPIABLE
RESTROOM
249
54 SF
NON-OCCUPIABLE
CLO
253
18 SF
CHILDREN
CHECK-I
259
152 SF
NON-OCCUPIA
FEC
32"
64"